


豊田市木土地区画整理事業

出来形確認測量原図

1:5000

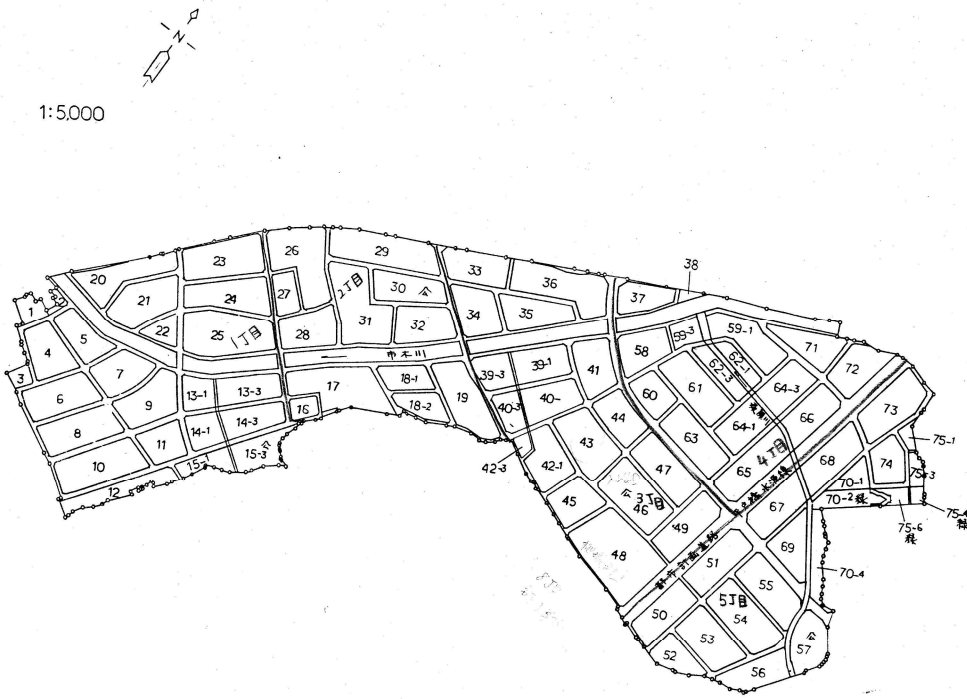

図面番号早見表

街区番号	図面番号	街区番号	図面番号	街区番号	図面番号	街区番号	図面番号
1		29		58	13	13-2	
2		30公	10	59-1	19	14-2	
3		31		59-3		15-2	
4		32		60	13	39-2	
5		33		61		40-2	
6		34	11	62-1	19	42-2	欠番
7		35		62-3		59-2	
8		36		63	15	62-2	
9		37		64-1		64-2	
10		38	12	64-3	19	70-3	
11		39-1		65		75-2	
12		39-3		66		75-5	
13-1		40		67	20		
13-3		40-3		68			
14-1		41		69			
14-3		42-1		70-1	21		
15-3		42-3		70-2緑			
16		43	14	70-4			
17		44		71			
18-1		45		72	22		
18-2		46公	14	73			
19		47	15	74			
20		48		75-1			
21		49		75-6			
22		50		75-6緑			
23		51					
24		52					
25		53	17				
26		54					
27		55	18				
28		56	17				
		57公	18				