
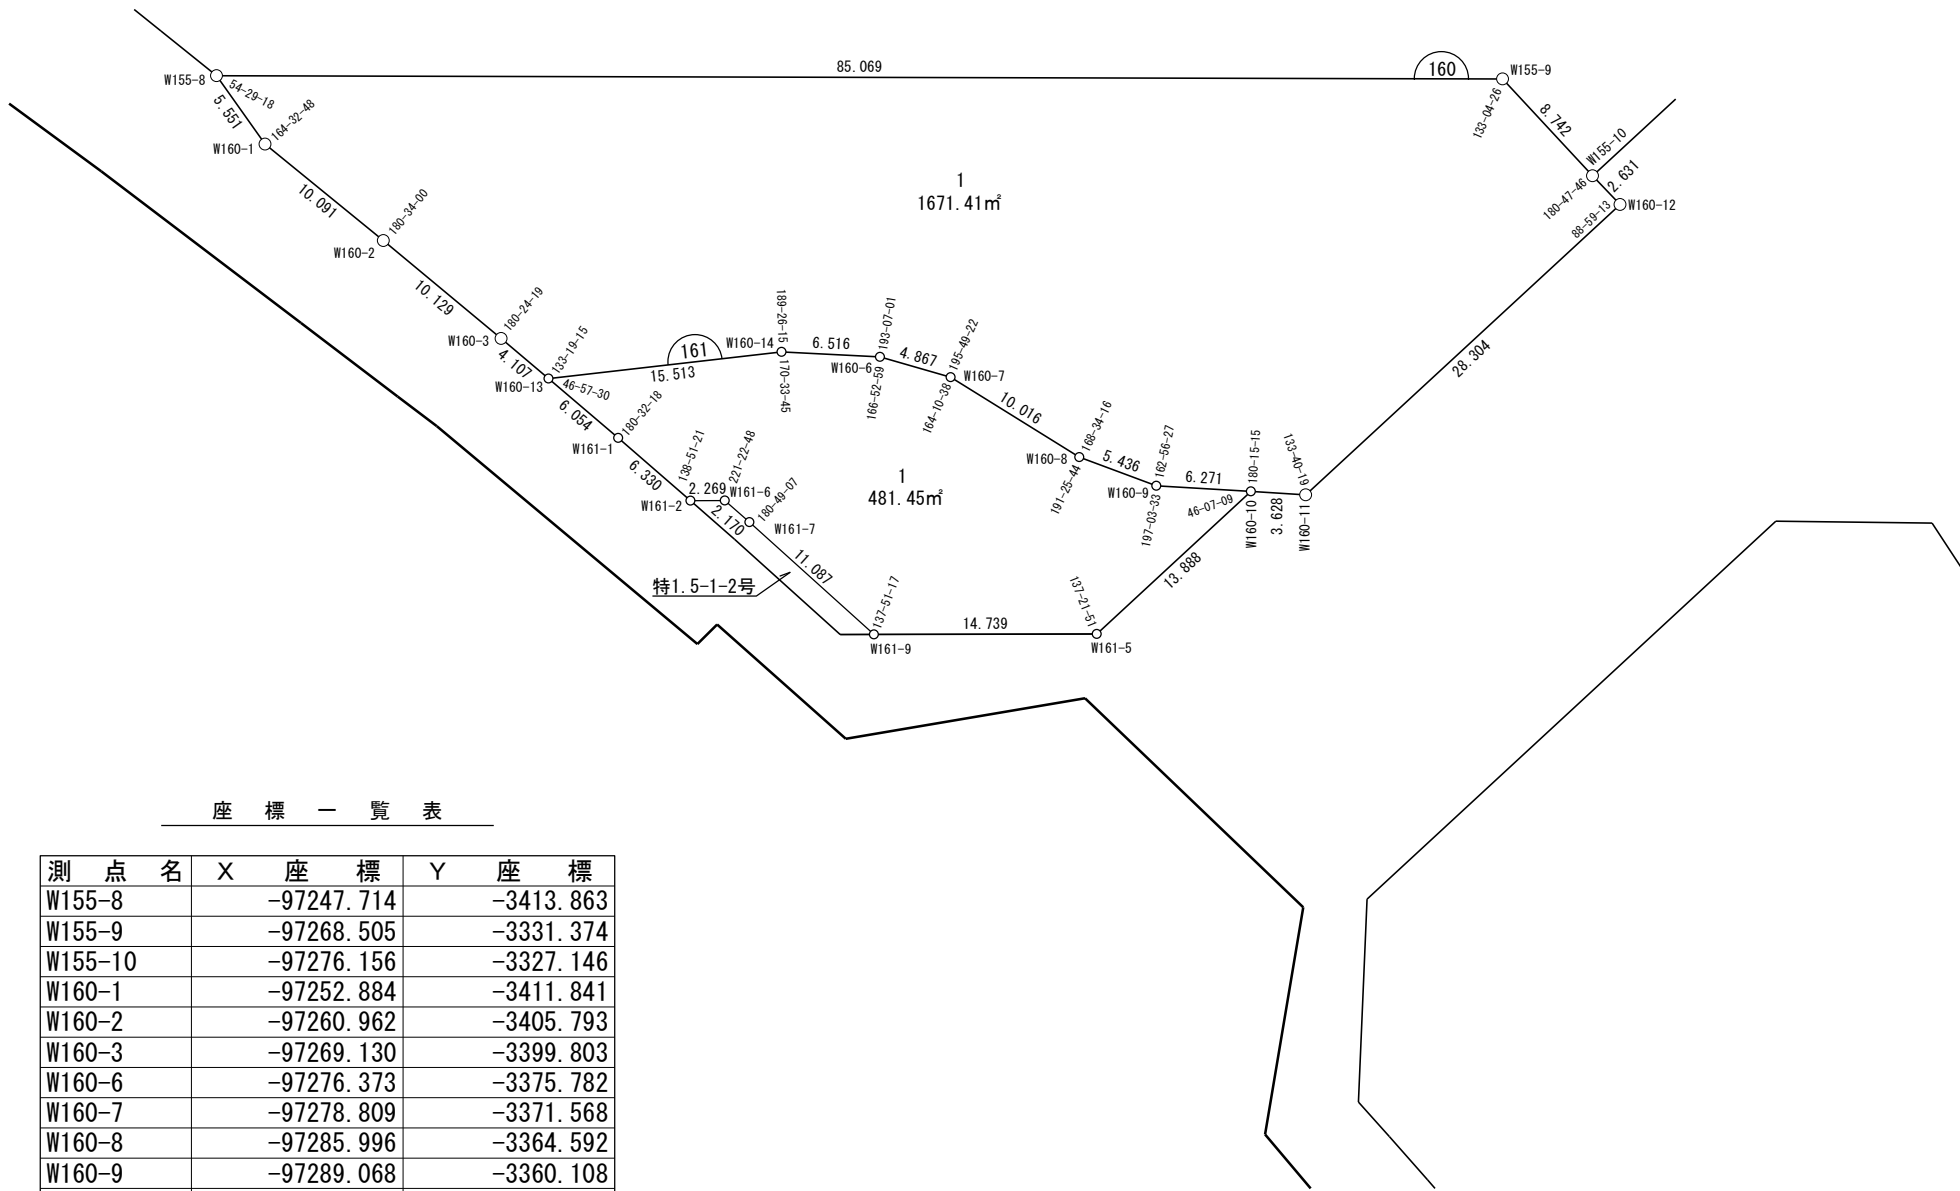


豊田浄水特定土地区画整理事業 画地出来形確認測量原図 縮尺＝１：５００ 160・161BLOCK

面積一覧表	
地番名	面積
W160-1	1671.41 m <sup>2</sup>
合計	1671.41 m <sup>2</sup>

面積一覧表	
地番名	面積
W161-1	481.45 m <sup>2</sup>
合計	481.45 m <sup>2</sup>

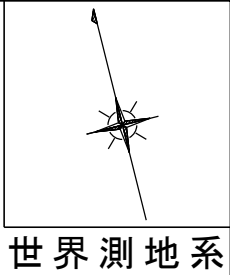

座 標 一 覧 表			
測 点 名	X 座 標	Y 座 標	
W155-8	-97247.714	-3413.863	
W155-9	-97268.505	-3331.374	
W155-10	-97276.156	-3327.146	
W160-1	-97252.884	-3411.841	
W160-2	-97260.962	-3405.793	
W160-3	-97269.130	-3399.803	
W160-6	-97276.373	-3375.782	
W160-7	-97278.809	-3371.568	
W160-8	-97285.996	-3364.592	
W160-9	-97289.068	-3360.108	
W160-10	-97290.940	-3354.123	
W160-11	-97292.038	-3350.665	
W160-12	-97278.441	-3325.841	
W160-13	-97272.460	-3397.398	
W160-14	-97274.478	-3382.017	
W161-1	-97277.384	-3393.877	
W161-2	-97282.567	-3390.244	
W161-5	-97297.621	-3366.298	
W161-6	-97283.109	-3388.040	
W161-7	-97284.891	-3386.802	
W161-9	-97294.085	-3380.606	

株式会社 オオバ 名古屋支店

豊田浄水特定土地区画整理組合

# 面積（座標法）計算書

地 番： W160-1

測点名	[1] X(i)	[2] X(i+1)-X(i-1)	[3] Y(i)	[4] Y(i+1)-Y(i-1)	[2]*[3]	[1]*[4]	方向角	夾 角	距 離
W155-8	-97247.714	15.621	-3413.863	-80.467	-53327.449544	7825194.114393	158-38-04	54-29-18	5.551
W160-1	-97252.884	-13.248	-3411.841	8.070	45200.445212	-784834.477305	143-10-52	164-32-48	10.091
W160-2	-97260.962	-16.247	-3405.793	12.037	55332.731929	-1170759.313365	143-44-52	180-34-00	10.129
W160-3	-97269.130	-11.497	-3399.803	8.395	39089.144111	-816571.777062	144-09-11	180-24-19	4.107
W160-13	-97272.460	-5.347	-3397.398	17.787	18166.669882	-1730177.221890	97-28-26	133-19-15	15.513
W160-14	-97274.478	-3.913	-3382.017	21.616	13235.300590	-2102693.323601	106-54-41	189-26-15	6.516
W160-6	-97276.373	-4.331	-3375.782	10.448	14620.992682	-1016369.184297	120-01-42	193-07-01	4.867
W160-7	-97278.809	-9.622	-3371.568	11.190	32442.516745	-1088563.966029	135-51-04	195-49-22	10.016
W160-8	-97285.996	-10.260	-3364.592	11.461	34519.658342	-1114949.654689	124-25-20	168-34-16	5.436
W160-9	-97289.068	-4.944	-3360.108	10.469	16613.082588	-1018524.637939	107-21-47	162-56-27	6.271
W160-10	-97290.940	-2.969	-3354.123	9.442	9959.266364	-918664.484225	107-37-02	180-15-15	3.628
W160-11	-97292.038	12.499	-3350.665	28.282	-41880.080928	-2751592.113997	61-17-21	133-40-19	28.304
W160-12	-97278.441	15.882	-3325.841	23.520	-52820.550809	-2287961.912478	330-16-34	88-59-13	2.631
W155-10	-97276.156	9.936	-3327.146	-5.533	-33059.003688	538239.476266	331-04-20	180-47-46	8.742
W155-9	-97268.505	28.442	-3331.374	-86.718	-94749.900957	8434885.653699	284-08-46	133-04-26	85.069
合計				倍面積 面積	3342.822521 1671.4112608	-3342.822521 1671.4112608			206.871

# 面積（座標法）計算書

地 番： W161-1

測点名	[1] X(i)	[2] X(i+1)-X(i-1)	[3] Y(i)	[4] Y(i+1)-Y(i-1)	[2]*[3]	[1]*[4]	方向角	夾 角	距 離
W161-1	-97277.384	-10.107	-3393.877	7.154	34302.883415	-695960.231011	144-58-14	180-32-18	6.330
W161-2	-97282.567	-5.725	-3390.244	5.837	19410.475169	-567798.652604	103-49-35	138-51-21	2.269
W161-6	-97283.109	-2.324	-3388.040	3.442	7874.850930	-334811.825500	145-12-23	221-22-48	2.170
W161-7	-97284.891	-10.976	-3386.802	7.434	37173.666743	-723201.268201	146-01-30	180-49-07	11.087
W161-9	-97294.085	-12.730	-3380.606	20.504	43033.896339	-1994925.291569	103-52-47	137-51-17	14.739
W161-5	-97297.621	3.146	-3366.298	26.484	-10588.937599	-2576798.487262	61-14-38	137-21-51	13.888
W160-10	-97290.940	8.553	-3354.123	6.190	-28686.222482	-602257.565323	287-21-47	46-07-09	6.271
W160-9	-97289.068	4.944	-3360.108	-10.469	-16613.082588	1018524.637939	304-25-20	197-03-33	5.436
W160-8	-97285.996	10.260	-3364.592	-11.461	-34519.658342	1114949.654689	315-51-04	191-25-44	10.016
W160-7	-97278.809	9.622	-3371.568	-11.190	-32442.516745	1088563.966029	300-01-42	164-10-38	4.867
W160-6	-97276.373	4.331	-3375.782	-10.448	-14620.992682	1016369.184297	286-54-41	166-52-59	6.516
W160-14	-97274.478	3.913	-3382.017	-21.616	-13235.300590	2102693.323601	277-28-26	170-33-45	15.513
W160-13	-97272.460	-2.906	-3397.398	-11.860	9873.838812	1153689.654536	144-25-56	46-57-30	6.054
合計				倍面積	962.900379	-962.900379			105.156
				面 積	481.4501900	481.4501900			