

豊田浄水特定土地区画整理事業


画地出来形確認測量原図

縮尺＝１：５００


１４１BLOCK

面積一覧表

地番名	地積	地番名	地積
W141-1-1	657.00㎡	W141-3-1	204.60㎡
W141-1-2	232.54㎡	W141-3-2	204.60㎡
W141-1-3	198.85㎡	W141-3-3	204.60㎡
W141-1-4	213.52㎡	W141-3-4	233.67㎡
W141-1-5	213.52㎡	W141-3-5	214.58㎡
W141-1-6	226.42㎡	W141-3-6	211.24㎡
W141-1-7	213.52㎡	W141-3-7	219.62㎡
W141-1-8	213.52㎡	W141-3-8	219.62㎡
W141-1-9	198.85㎡	W141-3-9	189.27㎡
W141-1-10	259.29㎡	W141-3-10	228.11㎡
W141-2-1	180.29㎡	W141-3-11	228.14㎡
W141-2-2	196.36㎡	W141-3-12	189.23㎡
W141-2-3	180.25㎡	W141-4	132.31㎡
W141-2-4	180.26㎡	W141-5	328.08㎡
W141-2-5	180.40㎡	W141-7	171.68㎡
W141-2-6	196.30㎡	合計	7100.42㎡
W141-2-7	180.18㎡		

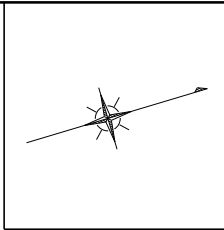

世界測地系

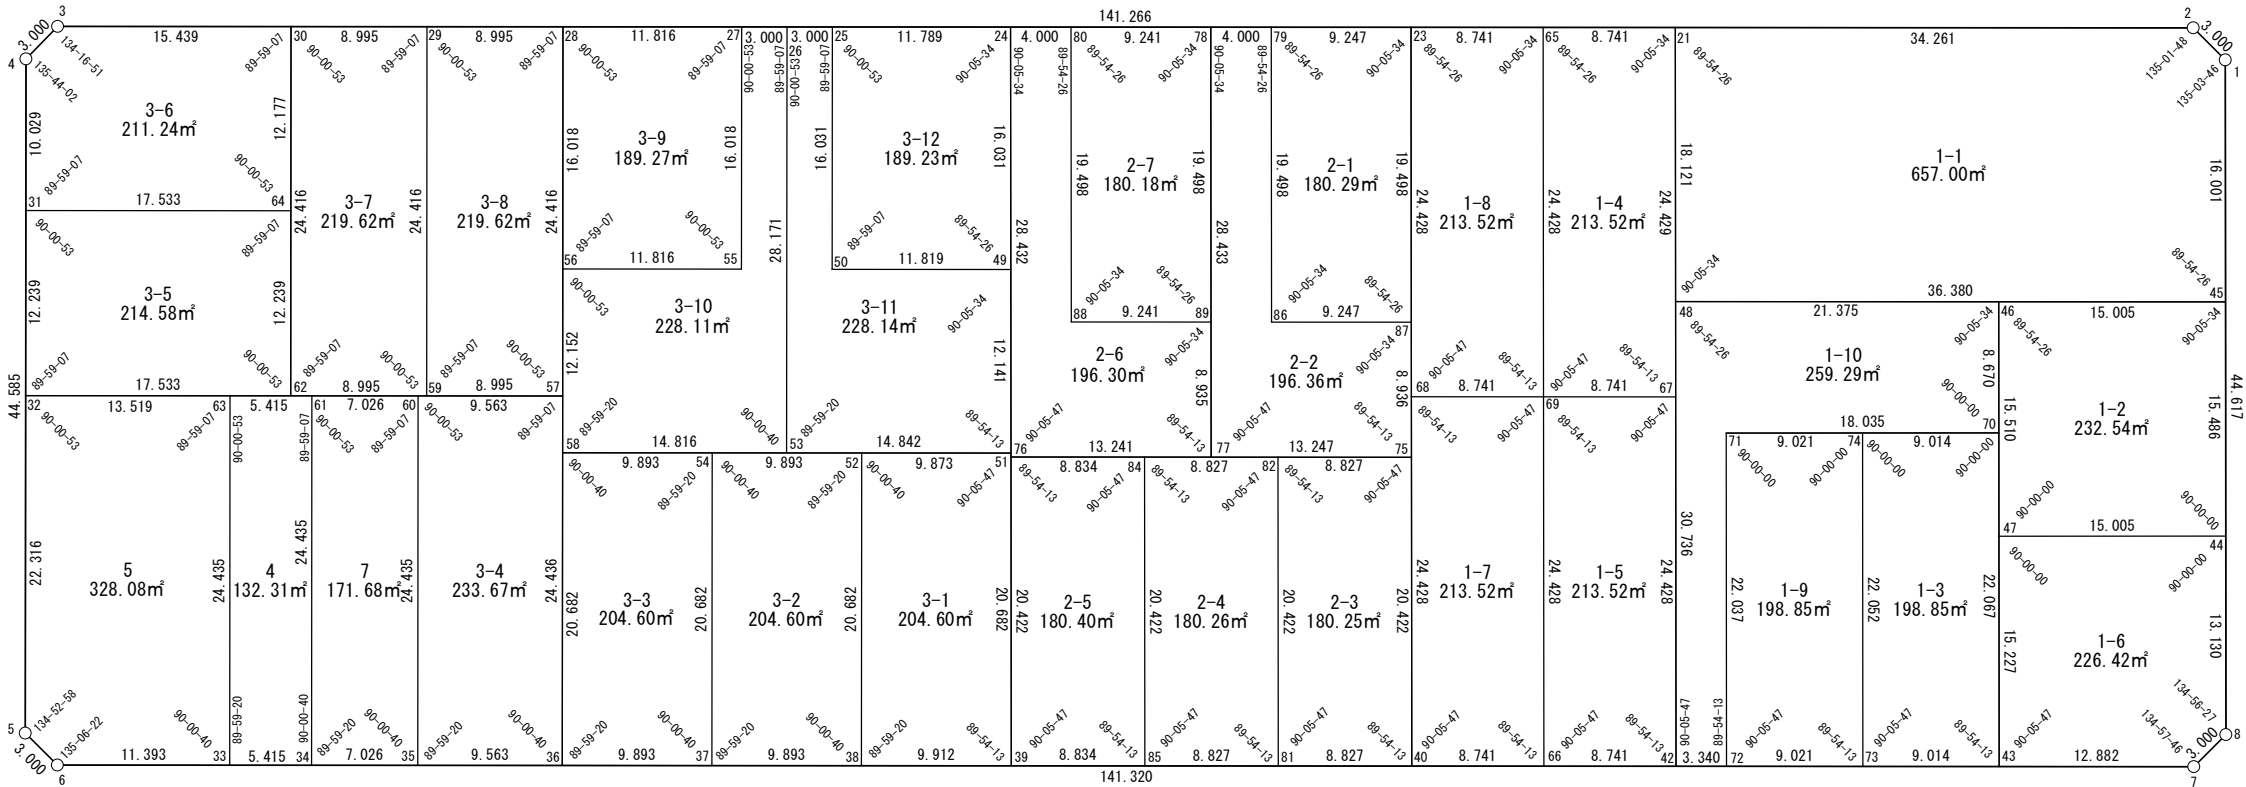

座 標 一 覧 表

測 点 名	X 座 標	Y 座 標
W141-1	-96755.833	-3175.288
W141-2	-96757.257	-3177.928
W141-3	-96892.569	-3218.506
W141-4	-96895.192	-3217.050
W141-5	-96908.009	-3174.348
W141-6	-96906.582	-3171.709
W141-7	-96771.220	-3131.106
W141-8	-96768.580	-3132.530
W141-21	-96790.074	-3187.769
W141-23	-96806.819	-3192.791
W141-24	-96832.191	-3200.400
W141-25	-96843.483	-3203.786
W141-26	-96846.357	-3204.648
W141-27	-96849.231	-3205.509
W141-28	-96860.549	-3208.904
W141-29	-96869.165	-3211.487

測 点 名	X 座 標	Y 座 標
W141-30	-96877.780	-3214.071
W141-31	-96898.075	-3207.444
W141-32	-96901.594	-3195.722
W141-33	-96895.669	-3168.435
W141-34	-96890.483	-3166.880
W141-35	-96883.753	-3164.861
W141-36	-96874.593	-3162.114
W141-37	-96865.118	-3159.272
W141-38	-96855.643	-3156.429
W141-39	-96846.149	-3153.582
W141-40	-96820.777	-3145.971
W141-42	-96804.032	-3140.949
W141-43	-96783.558	-3134.807
W141-44	-96764.828	-3145.113
W141-45	-96760.404	-3159.953
W141-46	-96774.777	-3164.264

測 点 名	X 座 標	Y 座 標
W141-47	-96779.208	-3149.400
W141-48	-96795.251	-3170.403
W141-49	-96836.771	-3185.037
W141-50	-96848.092	-3188.432
W141-51	-96840.240	-3173.402
W141-52	-96849.697	-3176.239
W141-53	-96854.456	-3177.666
W141-54	-96859.172	-3179.081
W141-55	-96853.836	-3170.168
W141-56	-96865.154	-3193.562
W141-57	-96867.568	-3185.518
W141-58	-96868.647	-3181.923
W141-59	-96876.184	-3188.102
W141-60	-96876.728	-3188.265
W141-61	-96883.458	-3190.283
W141-62	-96884.800	-3190.686

測 点 名	X 座 標	Y 座 標
W141-63	-96888.644	-3191.839
W141-64	-96881.281	-3202.408
W141-65	-96798.447	-3190.280
W141-66	-96812.445	-3143.460
W141-67	-96797.053	-3164.359
W141-68	-96813.798	-3169.381
W141-69	-96805.426	-3166.870
W141-70	-96777.254	-3155.955
W141-71	-96794.537	-3161.107
W141-72	-96800.833	-3139.989
W141-73	-96792.193	-3137.397
W141-74	-96785.892	-3158.530
W141-75	-96814.943	-3165.542
W141-76	-96840.314	-3173.152
W141-77	-96827.631	-3169.348
W141-78	-96819.508	-3196.596

測 点 名	X 座 標	Y 座 標
W141-79	-96815.676	-3195.447
W141-80	-96828.360	-3199.251
W141-81	-96829.232	-3148.507
W141-82	-96823.397	-3168.078
W141-84	-96831.852	-3170.614
W141-85	-96837.687	-3151.043
W141-86	-96821.247	-3176.761
W141-87	-96812.390	-3174.105
W141-88	-96833.930	-3180.565
W141-89	-96825.078	-3177.910

面積（座標法）計算書

地 番： W141-1-1

測点名	[1] X(i)	[2] X(i+1)-X(i-1)	[3] Y(i)	[4] Y(i+1)-Y(i-1)	[2]*[3]	[1]*[4]	方向角	夾 角	距 離
W141-2	-96757.257	-34.241	-3177.928	-12.482	108816.206994	1207684.888627	196-41-35	135-01-48	34.261
W141-21	-96790.074	-37.995	-3187.769	7.524	121117.944033	-728284.504548	106-36-01	89-54-26	18.121
W141-48	-96795.251	29.670	-3170.403	27.816	-94065.231767	-2692443.031117	16-41-35	90-05-34	36.380
W141-45	-96760.404	39.418	-3159.953	-4.884	-124560.117879	472599.686009	286-36-01	89-54-26	16.001
W141-1	-96755.833	3.148	-3175.288	-17.974	-9994.801379	1739128.961028	241-39-47	135-03-46	3.000
合計				倍面積	1314.000001	-1314.000001			107.763
				面 積	657.0000010	657.0000010			

面積（座標法）計算書

地番：W141-1-2

測点名	[1] X(i)	[2] X(i+1)-X(i-1)	[3] Y(i)	[4] Y(i+1)-Y(i-1)	[2]*[3]	[1]*[4]	方向角	夾角	距離
W141-44	-96764.828	18.804	-3145.113	-10.553	-59139.320872	1021190.469442	286-36-01	90-00-00	15.486
W141-45	-96760.404	-9.948	-3159.953	-19.150	31436.329134	1852980.775822	196-41-35	90-05-34	15.005
W141-46	-96774.777	-18.804	-3164.264	10.553	59499.412705	-1021295.457612	106-36-01	89-54-26	15.510
W141-47	-96779.208	9.948	-3149.400	19.150	-31331.340964	-1853340.867655	16-36-01	90-00-00	15.005
合計				倍面積	465.080001	-465.080001			61.006
				面積	232.5400010	232.5400010			

面積（座標法）計算書

地番：W141-1-3

測点名	[1] X(i)	[2] X(i+1)-X(i-1)	[3] Y(i)	[4] Y(i+1)-Y(i-1)	[2]*[3]	[1]*[4]	方向角	夾角	距離
W141-70	-96777.254	-2.334	-3155.955	-23.723	7366.893671	2295822.056426	196-36-01	90-00-00	9.014
W141-74	-96785.892	-14.939	-3158.530	18.557	47184.810432	-1796101.244996	106-36-01	90-00-00	22.052
W141-73	-96792.193	2.334	-3137.397	23.723	-7323.575273	-2296176.446962	16-41-48	90-05-47	9.014
W141-43	-96783.558	14.939	-3134.807	-18.557	-46830.419896	1796057.926599	286-36-01	89-54-13	22.067
合計				倍面積	397.708933	-397.708933			62.147
				面積	198.8544665	198.8544665			

面積（座標法）計算書

地番：W141-1-4

測点名	[1] X(i)	[2] X(i+1)-X(i-1)	[3] Y(i)	[4] Y(i+1)-Y(i-1)	[2]*[3]	[1]*[4]	方向角	夾角	距離
W141-21	-96790.074	-1.393	-3187.769	-25.922	4441.520222	2508948.440663	196-41-35	90-05-34	8.741
W141-65	-96798.447	-15.352	-3190.280	20.899	48975.792845	-2023034.512436	106-36-01	89-54-26	24.428
W141-69	-96805.426	1.393	-3166.870	25.922	-4412.401007	-2509346.376978	16-41-48	90-05-47	8.741
W141-67	-96797.053	15.352	-3164.359	-20.899	-48577.856529	2023005.393221	286-36-01	89-54-13	24.429
合計				倍面積	427.055530	-427.055530			66.339
				面積	213.5277652	213.5277652			

面積（座標法）計算書

地番：W141-1-5

測点名	[1] X(i)	[2] X(i+1)-X(i-1)	[3] Y(i)	[4] Y(i+1)-Y(i-1)	[2]*[3]	[1]*[4]	方向角	夾角	距離
W141-67	-96797.053	-1.393	-3164.359	-25.921	4409.226439	2509096.062083	196-41-48	90-05-47	8.741
W141-69	-96805.426	-15.351	-3166.870	20.899	48615.589102	-2023096.295040	106-36-01	89-54-13	24.428
W141-66	-96812.405	1.393	-3143.460	25.921	-4380.106291	-2509493.986408	16-41-48	90-05-47	8.741
W141-42	-96804.032	15.351	-3140.949	-20.899	-48217.664778	2023067.174893	286-36-01	89-54-13	24.428
合計				倍面積	427.044471	-427.044471			66.338
				面積	213.5222359	213.5222359			

面積（座標法）計算書

地番：W141-1-6

測点名	[1] X(i)	[2] X(i+1)-X(i-1)	[3] Y(i)	[4] Y(i+1)-Y(i-1)	[2]*[3]	[1]*[4]	方向角	夾角	距離
W141-7	-96771.220	14.979	-3131.106	2.277	-46899.599528	-220342.440116	331-39-34	134-57-46	3.000
W141-8	-96768.580	6.391	-3132.530	-14.007	-20021.191086	1355424.181537	286-36-01	134-56-27	13.130
W141-44	-96764.828	-10.628	-3145.113	-16.870	33426.978519	1632389.109087	196-36-01	90-00-00	15.005
W141-47	-96779.208	-18.730	-3149.400	10.306	58987.641996	-997398.803186	106-36-01	90-00-00	15.227
W141-43	-96783.558	7.988	-3134.807	18.294	-25040.989898	-1770524.887323	16-41-48	90-05-47	12.882
合計				倍面積	452.840002	-452.840002			59.244
				面積	226.4200011	226.4200011			

面積（座標法）計算書

地番：W141-1-7

測点名	[1] X(i)	[2] X(i+1)-X(i-1)	[3] Y(i)	[4] Y(i+1)-Y(i-1)	[2]*[3]	[1]*[4]	方向角	夾角	距離
W141-69	-96805.426	-1.393	-3166.870	-25.921	4413.022781	2509315.807477	196-41-48	90-05-47	8.741
W141-68	-96813.798	-15.351	-3169.381	20.899	48654.438727	-2023268.543249	106-36-01	89-54-13	24.428
W141-40	-96820.777	1.393	-3145.971	25.921	-4383.900712	-2509713.734665	16-41-48	90-05-47	8.741
W141-66	-96812.405	15.351	-3143.460	-20.899	-48256.511539	2023239.421180	286-36-01	89-54-13	24.428
合計				倍面積	427.049256	-427.049256			66.338
				面積	213.5246283	213.5246283			

面積（座標法）計算書

地番：W141-1-8

測点名	[1] X(i)	[2] X(i+1)-X(i-1)	[3] Y(i)	[4] Y(i+1)-Y(i-1)	[2]*[3]	[1]*[4]	方向角	夾角	距離
W141-65	-96798.447	-1.394	-3190.280	-25.921	4445.816702	2509117.413497	196-41-35	90-05-34	8.741
W141-23	-96806.819	-15.352	-3192.791	20.899	49014.137949	-2023155.988215	106-36-01	89-54-26	24.428
W141-68	-96813.798	1.394	-3169.381	25.921	-4416.693029	-2509515.340569	16-41-48	90-05-47	8.741
W141-69	-96805.426	15.352	-3166.870	-20.899	-48616.210877	2023126.864541	286-36-01	89-54-13	24.428
合計				倍面積	427.050745	-427.050745			66.338
				面積	213.5253728	213.5253728			

面積（座標法）計算書

地番：W141-1-9

測点名	[1] X(i)	[2] X(i+1)-X(i-1)	[3] Y(i)	[4] Y(i+1)-Y(i-1)	[2]*[3]	[1]*[4]	方向角	夾角	距離
W141-74	-96785.892	-2.345	-3158.530	-23.710	7405.396186	2294790.828102	196-36-01	90-00-00	9.021
W141-71	-96794.537	-14.940	-3161.107	18.541	47228.401853	-1794681.021901	106-36-01	90-00-00	22.037
W141-72	-96800.833	2.345	-3139.989	23.710	-7361.925180	-2295145.066029	16-41-48	90-05-47	9.021
W141-73	-96792.193	14.940	-3137.397	-18.541	-46874.163927	1794637.550895	286-36-01	89-54-13	22.052
合計				倍面積	397.708932	-397.708932			62.131
				面積	198.8544664	198.8544664			

面積（座標法）計算書

地 番： W141-1-10

測点名	[1] X(i)	[2] X(i+1)-X(i-1)	[3] Y(i)	[4] Y(i+1)-Y(i-1)	[2]*[3]	[1]*[4]	方向角	夾 角	距 離
W141-46	-96774.777	-17.997	-3164.264	-14.449	56948.550555	1398268.943947	196-41-35	90-05-34	21.375
W141-48	-96795.251	-29.255	-3170.403	23.315	92751.667526	-2256769.590092	106-36-01	89-54-26	30.736
W141-42	-96804.032	-5.582	-3140.949	30.414	17532.103594	-2944243.053668	16-41-48	90-05-47	3.340
W141-72	-96800.833	9.495	-3139.989	-20.159	-29814.376868	1951373.623961	286-36-01	89-54-13	22.037
W141-71	-96794.537	23.579	-3161.107	-15.966	-74536.371349	1545399.810384	16-36-01	270-00-00	18.035
W141-70	-96777.254	19.760	-3155.955	-3.156	-62362.991321	305451.683330	286-36-01	90-00-00	8.670
合計				倍面積	518.582136	-518.582136			104.193
				面 積	259.2910680	259.2910680			

面積（座標法）計算書

地番：W141-2-1

測点名	[1] X(i)	[2] X(i+1)-X(i-1)	[3] Y(i)	[4] Y(i+1)-Y(i-1)	[2]*[3]	[1]*[4]	方向角	夾角	距離
W141-23	-96806.819	-3.287	-3192.791	-21.342	10493.410684	2066042.096858	196-41-35	90-05-34	9.247
W141-79	-96815.676	-14.428	-3195.447	16.030	46103.242675	-1551920.385891	106-36-01	89-54-26	19.498
W141-86	-96821.247	3.287	-3176.761	21.342	-10440.727751	-2066350.013430	16-41-35	90-05-34	9.247
W141-87	-96812.390	14.428	-3174.105	-16.030	-45795.326103	1551867.702958	286-36-01	89-54-26	19.498
合計				倍面積	360.599504	-360.599504			57.490
				面積	180.2997524	180.2997524			

面積（座標法）計算書

地 番： W141-2-2

測点名	[1] X(i)	[2] X(i+1)-X(i-1)	[3] Y(i)	[4] Y(i+1)-Y(i-1)	[2]*[3]	[1]*[4]	方向角	夾 角	距 離
W141-87	-96812.390	-6.304	-3174.105	-11.219	20010.598921	1086172.547784	196-41-35	90-05-34	9.247
W141-86	-96821.247	-3.287	-3176.761	-21.342	10440.727751	2066350.013430	286-36-01	269-54-26	19.498
W141-79	-96815.676	1.739	-3195.447	-19.835	-5557.106694	1920318.444724	196-41-35	90-05-34	4.000
W141-78	-96819.508	-11.955	-3196.596	26.099	38214.520696	-2526910.147182	106-36-01	89-54-26	28.433
W141-77	-96827.631	4.565	-3169.348	31.054	-14468.889105	-3006899.110635	16-41-48	90-05-47	13.247
W141-75	-96814.943	15.241	-3165.542	-4.757	-48247.130320	460575.530629	286-36-01	89-54-13	8.936
合計				倍面積	392.721249	-392.721249			83.361
				面 積	196.3606248	196.3606248			

面積（座標法）計算書

地番：W141-2-3

測点名	[1] X(i)	[2] X(i+1)-X(i-1)	[3] Y(i)	[4] Y(i+1)-Y(i-1)	[2]*[3]	[1]*[4]	方向角	夾角	距離
W141-40	-96820.777	14.289	-3145.971	-17.035	-44953.053547	1649303.456534	286-36-01	89-54-13	20.422
W141-75	-96814.943	-2.620	-3165.542	-22.107	8294.712862	2140251.246260	196-41-48	90-05-47	8.827
W141-82	-96823.397	-14.289	-3168.078	17.035	45268.936948	-1649348.092537	106-36-01	89-54-13	20.422
W141-81	-96829.232	2.620	-3148.507	22.107	-8250.076859	-2140567.129661	16-41-48	90-05-47	8.827
合計				倍面積	360.519404	-360.519404			58.498
				面積	180.2597020	180.2597020			

面積（座標法）計算書

地番：W141-2-4

測点名	[1] X(i)	[2] X(i+1)-X(i-1)	[3] Y(i)	[4] Y(i+1)-Y(i-1)	[2]*[3]	[1]*[4]	方向角	夾角	距離
W141-82	-96823.397	-2.621	-3168.078	-22.107	8302.851158	2140451.839176	196-41-48	90-05-47	8.827
W141-84	-96831.852	-14.290	-3170.614	17.034	45306.670573	-1649478.433743	106-36-01	89-54-13	20.422
W141-85	-96837.687	2.621	-3151.043	22.107	-8258.207497	-2140767.735017	16-41-48	90-05-47	8.827
W141-81	-96829.232	14.290	-3148.507	-17.034	-44990.774732	1649433.790083	286-36-01	89-54-13	20.422
合計				倍面積	360.539501	-360.539501			58.498
				面積	180.2697507	180.2697507			

面積（座標法）計算書

地番：W141-2-5

測点名	[1] X(i)	[2] X(i+1)-X(i-1)	[3] Y(i)	[4] Y(i+1)-Y(i-1)	[2]*[3]	[1]*[4]	方向角	夾角	距離
W141-84	-96831.852	-2.627	-3170.614	-22.109	8330.325700	2140829.552684	196-41-48	90-05-47	8.834
W141-76	-96840.314	-14.296	-3173.152	17.032	45363.783715	-1649431.761125	106-36-01	89-54-13	20.422
W141-39	-96846.149	2.627	-3153.582	22.109	-8285.575316	-2141145.621914	16-41-48	90-05-47	8.834
W141-85	-96837.687	14.296	-3151.043	-17.032	-45047.714485	1649387.010741	286-36-01	89-54-13	20.422
合計				倍面積	360.819613	-360.819613			58.512
				面積	180.4098066	180.4098066			

面積（座標法）計算書

地番：W141-2-6

測点名	[1] X(i)	[2] X(i+1)-X(i-1)	[3] Y(i)	[4] Y(i+1)-Y(i-1)	[2]*[3]	[1]*[4]	方向角	夾角	距離
W141-89	-96825.078	-6.299	-3177.910	-11.217	20018.223168	1086091.918378	196-41-35	90-05-34	9.241
W141-88	-96833.930	-3.281	-3180.565	-21.340	10436.282968	2066455.581004	286-36-01	269-54-26	19.498
W141-80	-96828.360	1.739	-3199.251	-19.835	-5563.627288	1920560.469159	196-41-35	90-05-34	4.000
W141-24	-96832.191	-11.955	-3200.400	26.098	38259.232904	-2527164.220825	106-36-01	89-54-26	28.432
W141-76	-96840.314	4.560	-3173.152	31.052	-14470.009371	-3007060.402266	16-41-48	90-05-47	13.241
W141-77	-96827.631	15.236	-3169.348	-4.758	-48287.501145	460724.053312	286-36-01	89-54-13	8.935
合計				倍面積	392.601235	-392.601235			83.347
				面積	196.3006179	196.3006179			

面積（座標法）計算書

地番：W141-2-7

測点名	[1] X(i)	[2] X(i+1)-X(i-1)	[3] Y(i)	[4] Y(i+1)-Y(i-1)	[2]*[3]	[1]*[4]	方向角	夾角	距離
W141-78	-96819.508	-3.281	-3196.596	-21.340	10488.885445	2066147.803988	196-41-35	90-05-34	9.241
W141-80	-96828.360	-14.422	-3199.251	16.031	46140.885948	-1552269.710385	106-36-01	89-54-26	19.498
W141-88	-96833.930	3.281	-3180.565	21.340	-10436.282968	-2066455.581004	16-41-35	90-05-34	9.241
W141-89	-96825.078	14.422	-3177.910	-16.031	-45833.108932	1552217.107908	286-36-01	89-54-26	19.498
合計				倍面積	360.379492	-360.379492			57.478
				面積	180.1897464	180.1897464			

面積（座標法）計算書

地 番： W141-3-1

測点名	[1] X(i)	[2] X(i+1)-X(i-1)	[3] Y(i)	[4] Y(i+1)-Y(i-1)	[2]*[3]	[1]*[4]	方向角	夾 角	距 離
W141-39	-96846.149	15.403	-3153.582	-16.973	-48574.113408	1643727.906736	286-36-01	89-54-13	20.682
W141-51	-96840.240	-3.548	-3173.402	-22.657	11259.284222	2194102.316963	196-41-48	90-05-47	9.873
W141-52	-96849.697	-15.403	-3176.239	16.973	48923.094447	-1643788.125700	106-42-28	90-00-40	20.682
W141-38	-96855.643	3.548	-3156.429	22.657	-11199.065259	-2194451.298001	16-41-48	89-59-20	9.912
合計				倍面積	409.200002	-409.200002			61.149
				面 積	204.6000010	204.6000010			

面積（座標法）計算書

地番：W141-3-2

測点名	[1] X(i)	[2] X(i+1)-X(i-1)	[3] Y(i)	[4] Y(i+1)-Y(i-1)	[2]*[3]	[1]*[4]	方向角	夾角	距離
W141-52	-96849.697	-3.529	-3176.239	-22.651	11210.327494	2193776.765994	196-41-48	89-59-20	9.893
W141-54	-96859.172	-15.421	-3179.081	16.967	49025.945952	-1643409.081190	106-42-28	90-00-40	20.682
W141-37	-96865.118	3.529	-3159.272	22.651	-11150.443587	-2194126.082089	16-41-48	89-59-20	9.893
W141-38	-96855.643	15.421	-3156.429	-16.967	-48676.629857	1643349.197284	286-42-28	90-00-40	20.682
合計				倍面積	409.200002	-409.200002			61.150
				面積	204.6000011	204.6000011			

面積（座標法）計算書

地番：W141-3-3

測点名	[1] X(i)	[2] X(i+1)-X(i-1)	[3] Y(i)	[4] Y(i+1)-Y(i-1)	[2]*[3]	[1]*[4]	方向角	夾角	距離
W141-54	-96859.172	-3.529	-3179.081	-22.651	11220.358782	2193991.396314	196-41-48	89-59-20	9.893
W141-58	-96868.647	-15.421	-3181.923	16.967	49069.776403	-1643569.850740	106-42-28	90-00-40	20.682
W141-36	-96874.593	3.529	-3162.114	22.651	-11160.474875	-2194340.712410	16-41-48	89-59-20	9.893
W141-37	-96865.118	15.421	-3159.272	-16.967	-48720.460308	1643509.966834	286-42-28	90-00-40	20.682
合計				倍面積	409.200002	-409.200002			61.150
				面積	204.6000010	204.6000010			

面積（座標法）計算書

地番：W141-3-4

測点名	[1] X(i)	[2] X(i+1)-X(i-1)	[3] Y(i)	[4] Y(i+1)-Y(i-1)	[2]*[3]	[1]*[4]	方向角	夾角	距離
W141-35	-96883.753	2.134	-3164.861	26.151	-6755.264877	-2533633.961371	16-41-48	89-59-20	9.563
W141-36	-96874.593	16.185	-3162.114	-20.657	-51177.595257	2001143.236920	286-42-28	90-00-40	24.436
W141-57	-96867.568	-2.134	-3185.518	-26.151	6799.356492	2533210.712985	196-41-35	89-59-07	9.563
W141-60	-96876.728	-16.185	-3188.265	20.657	51600.843644	-2001187.328536	106-42-28	90-00-53	24.435
合計				倍面積	467.340001	-467.340001			67.997
				面積	233.6700010	233.6700010			

面積（座標法）計算書

地番：W141-3-5

測点名	[1] X(i)	[2] X(i+1)-X(i-1)	[3] Y(i)	[4] Y(i+1)-Y(i-1)	[2]*[3]	[1]*[4]	方向角	夾角	距離
W141-32	-96901.594	13.275	-3195.722	16.759	-42424.105137	-1623953.950576	16-41-35	89-59-07	17.533
W141-62	-96884.800	20.313	-3190.686	-6.686	-64811.267396	647800.977655	286-42-28	90-00-53	12.239
W141-64	-96881.281	-13.275	-3202.408	-16.759	42512.867666	1623613.535105	196-41-35	89-59-07	17.533
W141-31	-96898.075	-20.313	-3207.444	6.686	65151.682867	-647889.740185	106-42-28	90-00-53	12.239
合計				倍面積	429.177999	-429.177999			59.544
				面積	214.5890000	214.5890000			

面積（座標法）計算書

地番：W141-3-6

測点名	[1] X(i)	[2] X(i+1)-X(i-1)	[3] Y(i)	[4] Y(i+1)-Y(i-1)	[2]*[3]	[1]*[4]	方向角	夾角	距離
W141-64	-96881.281	20.295	-3202.408	-6.627	-64992.056515	641999.642900	286-42-28	90-00-53	12.177
W141-30	-96877.780	-11.288	-3214.071	-16.098	36279.511218	1559514.115643	196-41-35	89-59-07	15.439
W141-3	-96892.569	-17.411	-3218.506	-2.979	56038.549270	288681.369910	150-58-26	134-16-51	3.000
W141-4	-96895.192	-5.506	-3217.050	11.062	17713.886074	-1071806.299959	106-42-28	135-44-02	10.029
W141-31	-96898.075	13.911	-3207.444	14.642	-44617.391728	-1418811.326812	16-41-35	89-59-07	17.533
合計				倍面積	422.498318	-422.498318			58.178
				面積	211.2491591	211.2491591			

面積（座標法）計算書

地番：W141-3-7

測点名	[1] X(i)	[2] X(i+1)-X(i-1)	[3] Y(i)	[4] Y(i+1)-Y(i-1)	[2]*[3]	[1]*[4]	方向角	夾角	距離
W141-29	-96869.165	-1.596	-3211.487	-25.969	5126.496029	2515613.853338	196-41-35	89-59-07	8.995
W141-30	-96877.780	-15.635	-3214.071	20.802	50252.732927	-2015225.023502	106-42-28	90-00-53	24.416
W141-62	-96884.800	1.596	-3190.686	25.969	-5093.290242	-2516019.887553	16-41-35	89-59-07	8.995
W141-59	-96876.184	15.635	-3188.102	-20.802	-49846.698712	2015191.817715	286-42-28	90-00-53	24.416
合計				倍面積	439.240002	-439.240002			66.822
				面積	219.6200011	219.6200011			

面積（座標法）計算書

地番：W141-3-8

測点名	[1] X(i)	[2] X(i+1)-X(i-1)	[3] Y(i)	[4] Y(i+1)-Y(i-1)	[2]*[3]	[1]*[4]	方向角	夾角	距離
W141-57	-96867.568	15.635	-3185.518	-20.802	-49806.301464	2015012.594963	286-42-28	90-00-53	24.416
W141-28	-96860.549	-1.596	-3208.904	-25.969	5122.371585	2515390.108926	196-41-35	89-59-07	8.995
W141-29	-96869.165	-15.635	-3211.487	20.802	50212.335679	-2015045.800750	106-42-28	90-00-53	24.416
W141-59	-96876.184	1.596	-3188.102	25.969	-5089.165799	-2515796.143141	16-41-35	89-59-07	8.995
合計				倍面積	439.240001	-439.240001			66.822
				面積	219.6200010	219.6200010			

面積（座標法）計算書

地番：W141-3-9

測点名	[1] X(i)	[2] X(i+1)-X(i-1)	[3] Y(i)	[4] Y(i+1)-Y(i-1)	[2]*[3]	[1]*[4]	方向角	夾角	距離
W141-27	-96849.231	-6.713	-3205.509	-18.736	21519.586672	1814543.821662	196-41-35	89-59-07	11.816
W141-28	-96860.549	-15.923	-3208.904	11.947	51096.272710	-1157231.652549	106-42-28	90-00-53	16.018
W141-56	-96865.154	6.713	-3193.562	18.736	-21439.380047	-1814842.156406	16-41-35	89-59-07	11.816
W141-55	-96853.836	15.923	-3190.168	-11.947	-50797.937966	1157151.445923	286-42-28	90-00-53	16.018
合計				倍面積	378.541370	-378.541370			55.668
				面積	189.2706851	189.2706851			

面積（座標法）計算書

地番：W141-3-10

測点名	[1] X(i)	[2] X(i+1)-X(i-1)	[3] Y(i)	[4] Y(i+1)-Y(i-1)	[2]*[3]	[1]*[4]	方向角	夾角	距離
W141-26	-96846.357	5.225	-3204.648	-27.843	-16745.346542	2696528.161312	196-41-35	89-59-07	3.000
W141-27	-96849.231	-7.479	-3205.509	14.480	23972.576417	-1402361.363493	106-42-28	90-00-53	16.018
W141-55	-96853.836	-15.923	-3190.168	11.947	50797.937966	-1157151.445923	196-41-35	269-59-07	11.816
W141-56	-96865.154	-14.812	-3193.562	8.245	47302.873499	-798650.830813	106-42-28	90-00-53	12.152
W141-58	-96868.647	10.698	-3181.923	15.896	-34040.049058	-1539820.393646	16-41-48	89-59-20	14.816
W141-53	-96854.456	22.291	-3177.666	-22.725	-70831.771657	2200999.651941	286-42-28	90-00-40	28.171
合計				倍面積	456.220623	-456.220623			85.973
				面積	228.1103120	228.1103120			

面積（座標法）計算書

地 番： W141-3-11

測点名	[1] X(i)	[2] X(i+1)-X(i-1)	[3] Y(i)	[4] Y(i+1)-Y(i-1)	[2]*[3]	[1]*[4]	方向角	夾 角	距 離
W141-25	-96843.483	1.735	-3203.786	-16.216	-5559.236333	1570410.085228	196-41-35	89-59-07	3.000
W141-26	-96846.357	-10.972	-3204.648	26.120	35162.907446	-2529615.641191	106-42-28	90-00-53	28.171
W141-53	-96854.456	6.117	-3177.666	31.246	-19438.425245	-3026293.071907	16-41-48	89-59-20	14.842
W141-51	-96840.240	17.685	-3173.402	-7.371	-56120.589642	713778.053456	286-36-01	89-54-13	12.141
W141-49	-96836.771	-7.852	-3185.037	-15.030	25010.215710	1455439.259982	196-41-35	90-05-34	11.819
W141-50	-96848.092	-6.712	-3188.432	-18.749	21401.408892	1815825.033603	286-42-28	270-00-53	16.031
合計				倍面積	456.280828	-456.280828			86.004
				面 積	228.1404142	228.1404142			

面積（座標法）計算書

地番：W141-3-12

測点名	[1] X(i)	[2] X(i+1)-X(i-1)	[3] Y(i)	[4] Y(i+1)-Y(i-1)	[2]*[3]	[1]*[4]	方向角	夾角	距離
W141-24	-96832.191	-6.712	-3200.400	-18.749	21481.739722	1815526.903262	196-41-35	90-05-34	11.789
W141-25	-96843.483	-15.901	-3203.786	11.968	50943.260887	-1159010.624627	106-42-28	90-00-53	16.031
W141-50	-96848.092	6.712	-3188.432	18.749	-21401.408892	-1815825.033603	16-41-35	89-59-07	11.819
W141-49	-96836.771	15.901	-3185.037	-11.968	-50645.130546	1158930.293797	286-36-01	89-54-26	16.031
合計				倍面積	378.461171	-378.461171			55.670
				面積	189.2305857	189.2305857			

面積（座標法）計算書

地番：W141-4

測点名	[1] X(i)	[2] X(i+1)-X(i-1)	[3] Y(i)	[4] Y(i+1)-Y(i-1)	[2]*[3]	[1]*[4]	方向角	夾角	距離
W141-33	-96895.669	-1.838	-3168.435	24.959	5824.399761	-2418403.321456	16-41-48	89-59-20	5.415
W141-34	-96890.483	12.211	-3166.880	-21.848	-38671.962345	2116838.830540	286-42-28	90-00-40	24.435
W141-61	-96883.458	1.838	-3190.283	-24.959	-5864.561545	2418098.539671	196-41-35	89-59-07	5.415
W141-63	-96888.644	-12.211	-3191.839	21.848	38976.744130	-2116798.668756	106-42-28	90-00-53	24.435
合計				倍面積	264.620001	-264.620001			59.700
				面積	132.3100010	132.3100010			

面積（座標法）計算書

地 番： W141-5

測点名	[1] X(i)	[2] X(i+1)-X(i-1)	[3] Y(i)	[4] Y(i+1)-Y(i-1)	[2]*[3]	[1]*[4]	方向角	夾 角	距 離
W141-32	-96901.594	-19.365	-3195.722	17.491	61885.577954	-1694873.075841	106-42-28	90-00-53	22.316
W141-5	-96908.009	-4.988	-3174.348	24.013	15834.140694	-2327065.024577	61-35-26	134-52-58	3.000
W141-6	-96906.582	12.340	-3171.709	5.912	-39140.040768	-572957.069668	16-41-48	135-06-22	11.393
W141-33	-96895.669	17.938	-3168.435	-20.130	-56834.101689	1950490.507426	286-42-28	90-00-40	24.435
W141-63	-96888.644	-5.925	-3191.839	-27.286	18910.583810	2643748.502659	196-41-35	89-59-07	13.519
合計				倍面積	656.160002	-656.160002			74.663
				面 積	328.0800011	328.0800011			

面積（座標法）計算書

地番：W141-7

測点名	[1] X(i)	[2] X(i+1)-X(i-1)	[3] Y(i)	[4] Y(i+1)-Y(i-1)	[2]*[3]	[1]*[4]	方向角	夾角	距離
W141-34	-96890.483	-0.295	-3166.880	25.422	934.768924	-2463154.223887	16-41-48	89-59-20	7.026
W141-35	-96883.753	13.755	-3164.861	-21.385	-43531.677668	2071886.863959	286-42-28	90-00-40	24.435
W141-60	-96876.728	0.295	-3188.265	-25.422	-941.081226	2462804.551583	196-41-35	89-59-07	7.026
W141-61	-96883.458	-13.755	-3190.283	21.385	43881.349972	-2071880.551657	106-42-28	90-00-53	24.435
合計				倍面積	343.360001	-343.360001			62.922
				面積	171.6800010	171.6800010			